




ENGINEERING DEPARTMENT

VISVA BHARATI, SANTINIKETAN


ANANDA SADAN HOSTEL

INVITEES & PARTICIPANTS

INVITEES & PARTICIPANTS

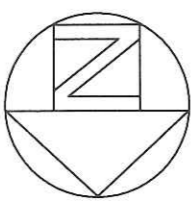

VASANTA UTSAVA GROUND

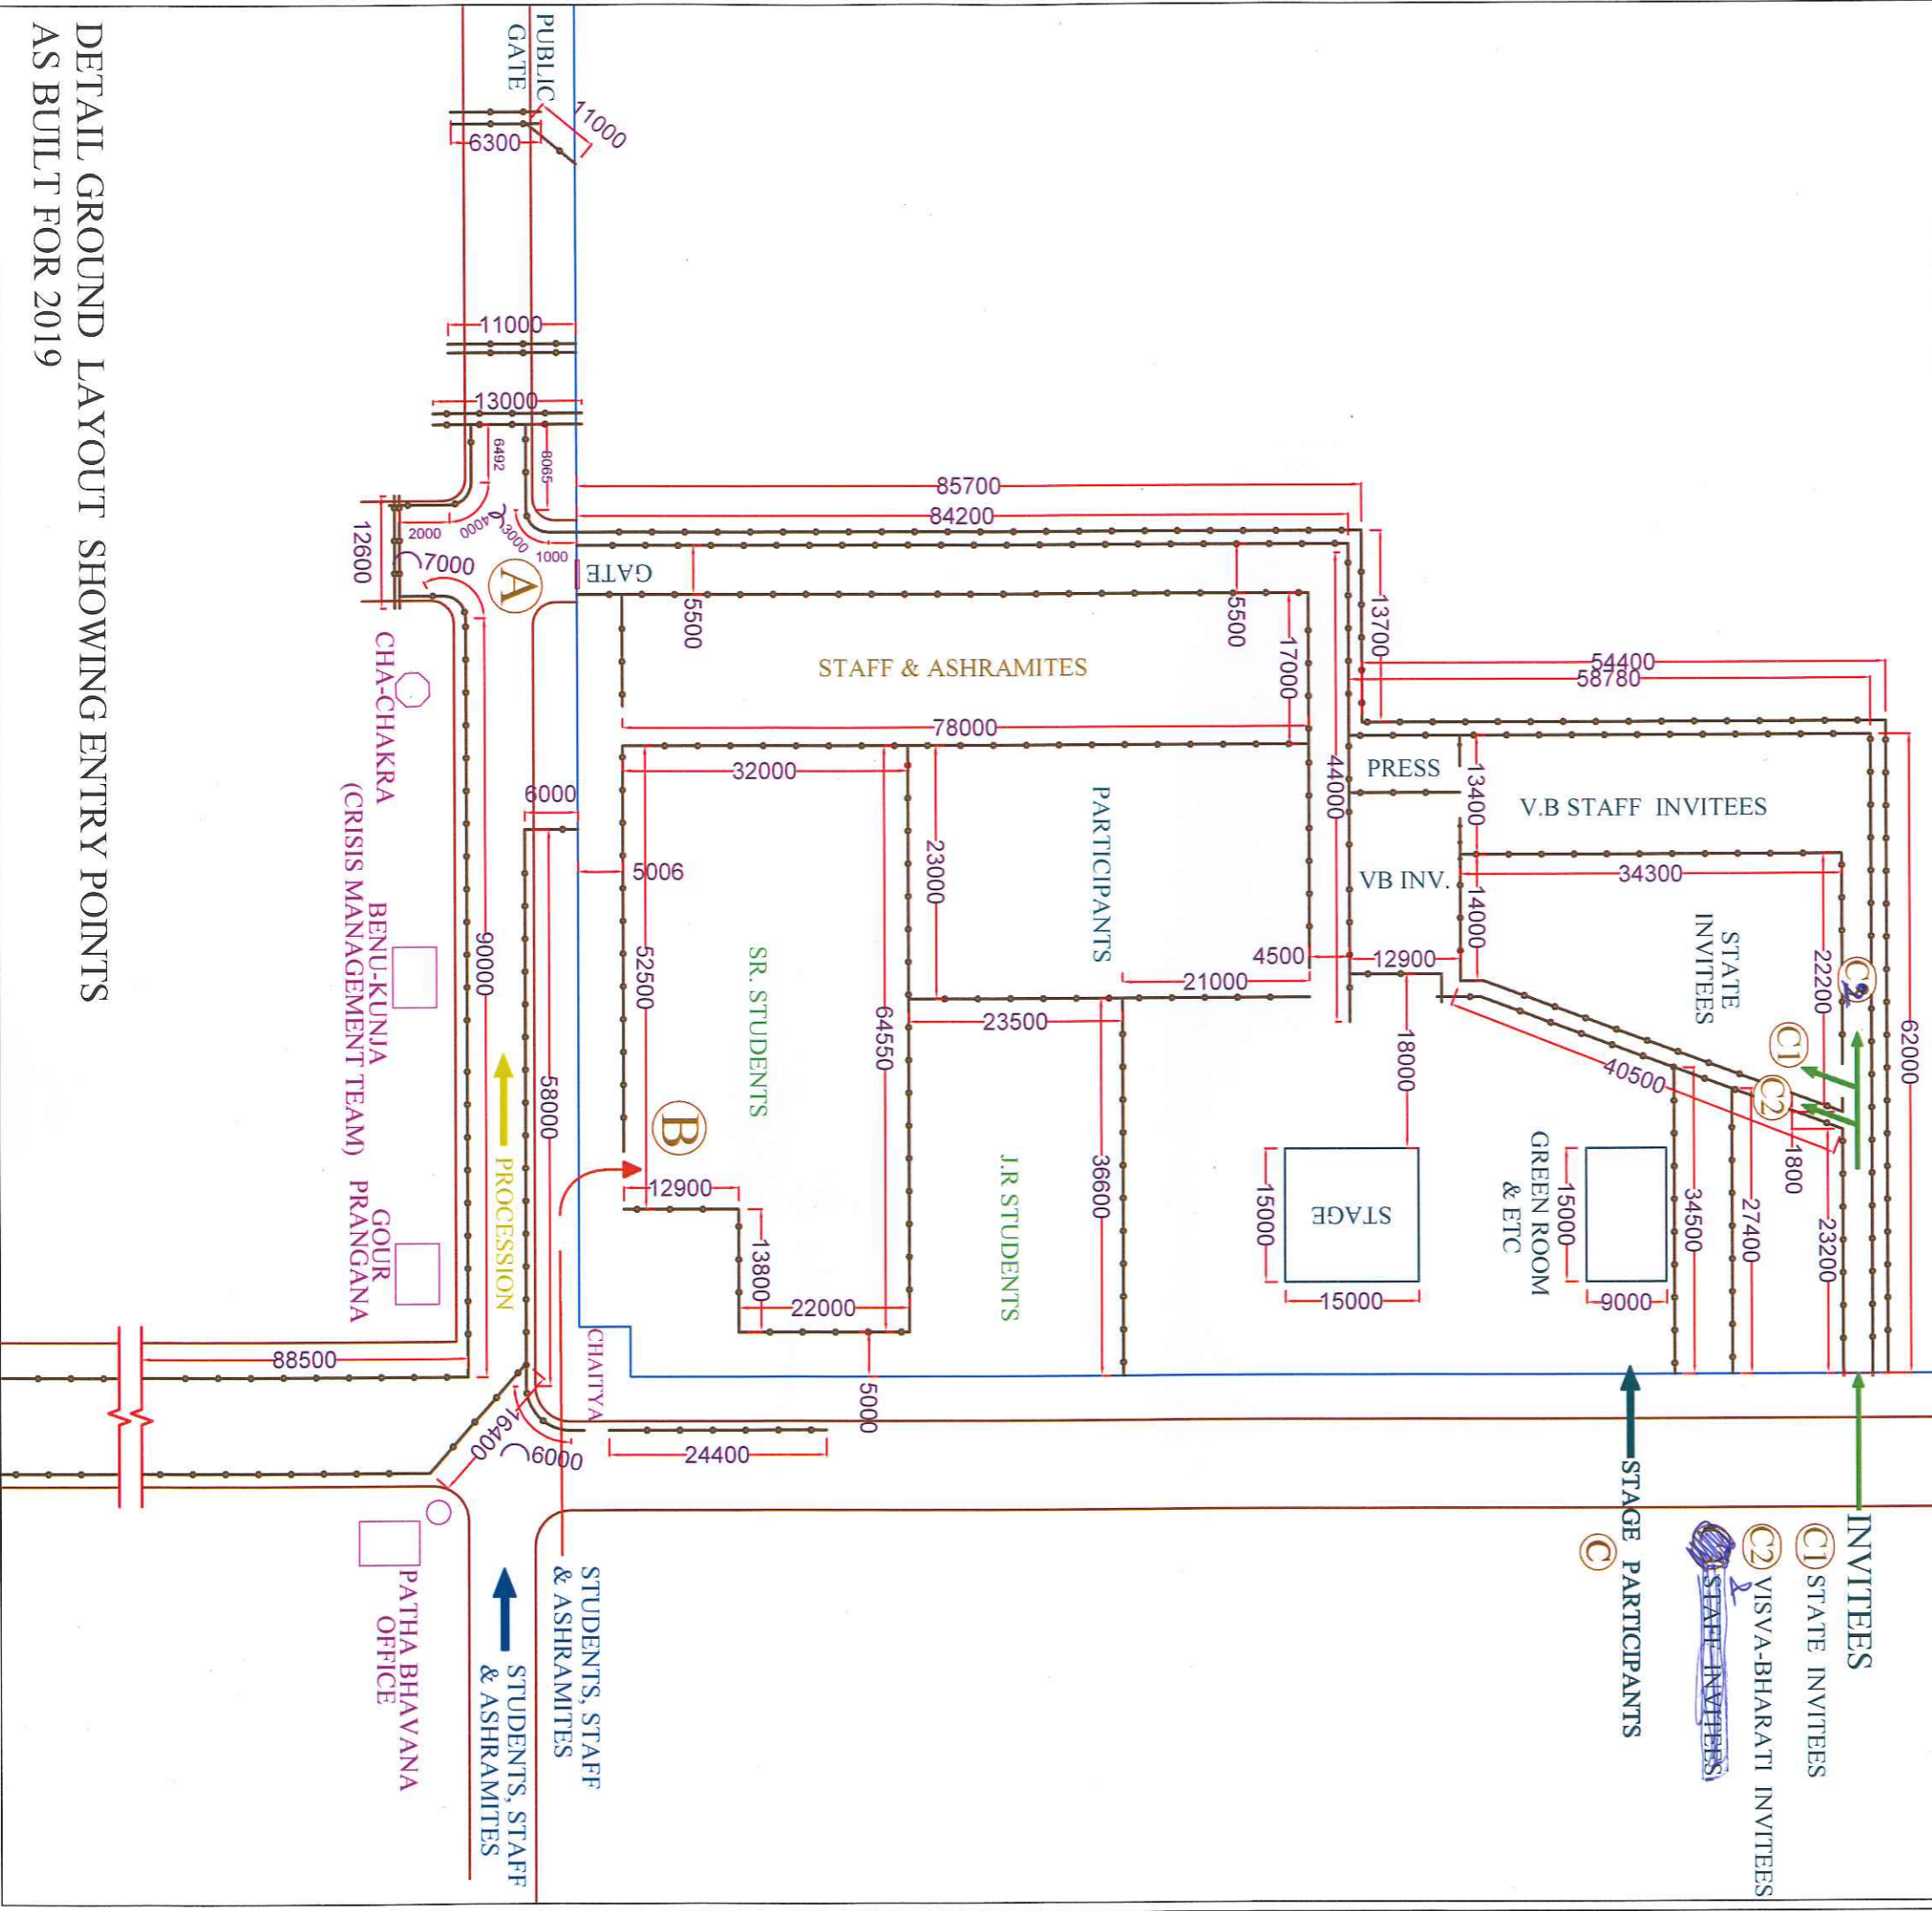

DETAIL GROUND LAYOUT SHOWING ENTRY POINTS
AS BUILT FOR 2019